

"Name"
Address City CA Zip Code

DESCRIPTION:

As Built
Plan View

DATE:

4/13/17

SCALE:

1"=2'

DRAWN BY:

DH

REVISIONS:

--

SHEET

1 OF 1

"Name"
Address City CA Zip Code

DESCRIPTION:

Wall 5
Elevation

DATE:

4/12/17

SCALE:

1"=1'

DRAWN BY:



DH

REVISIONS:

--

SHEET

1 OF 1

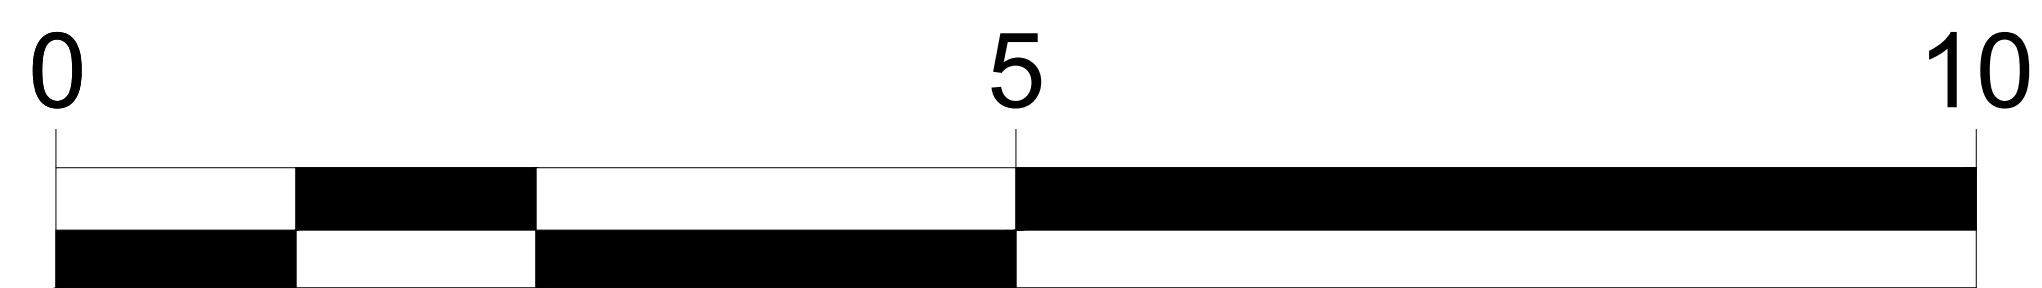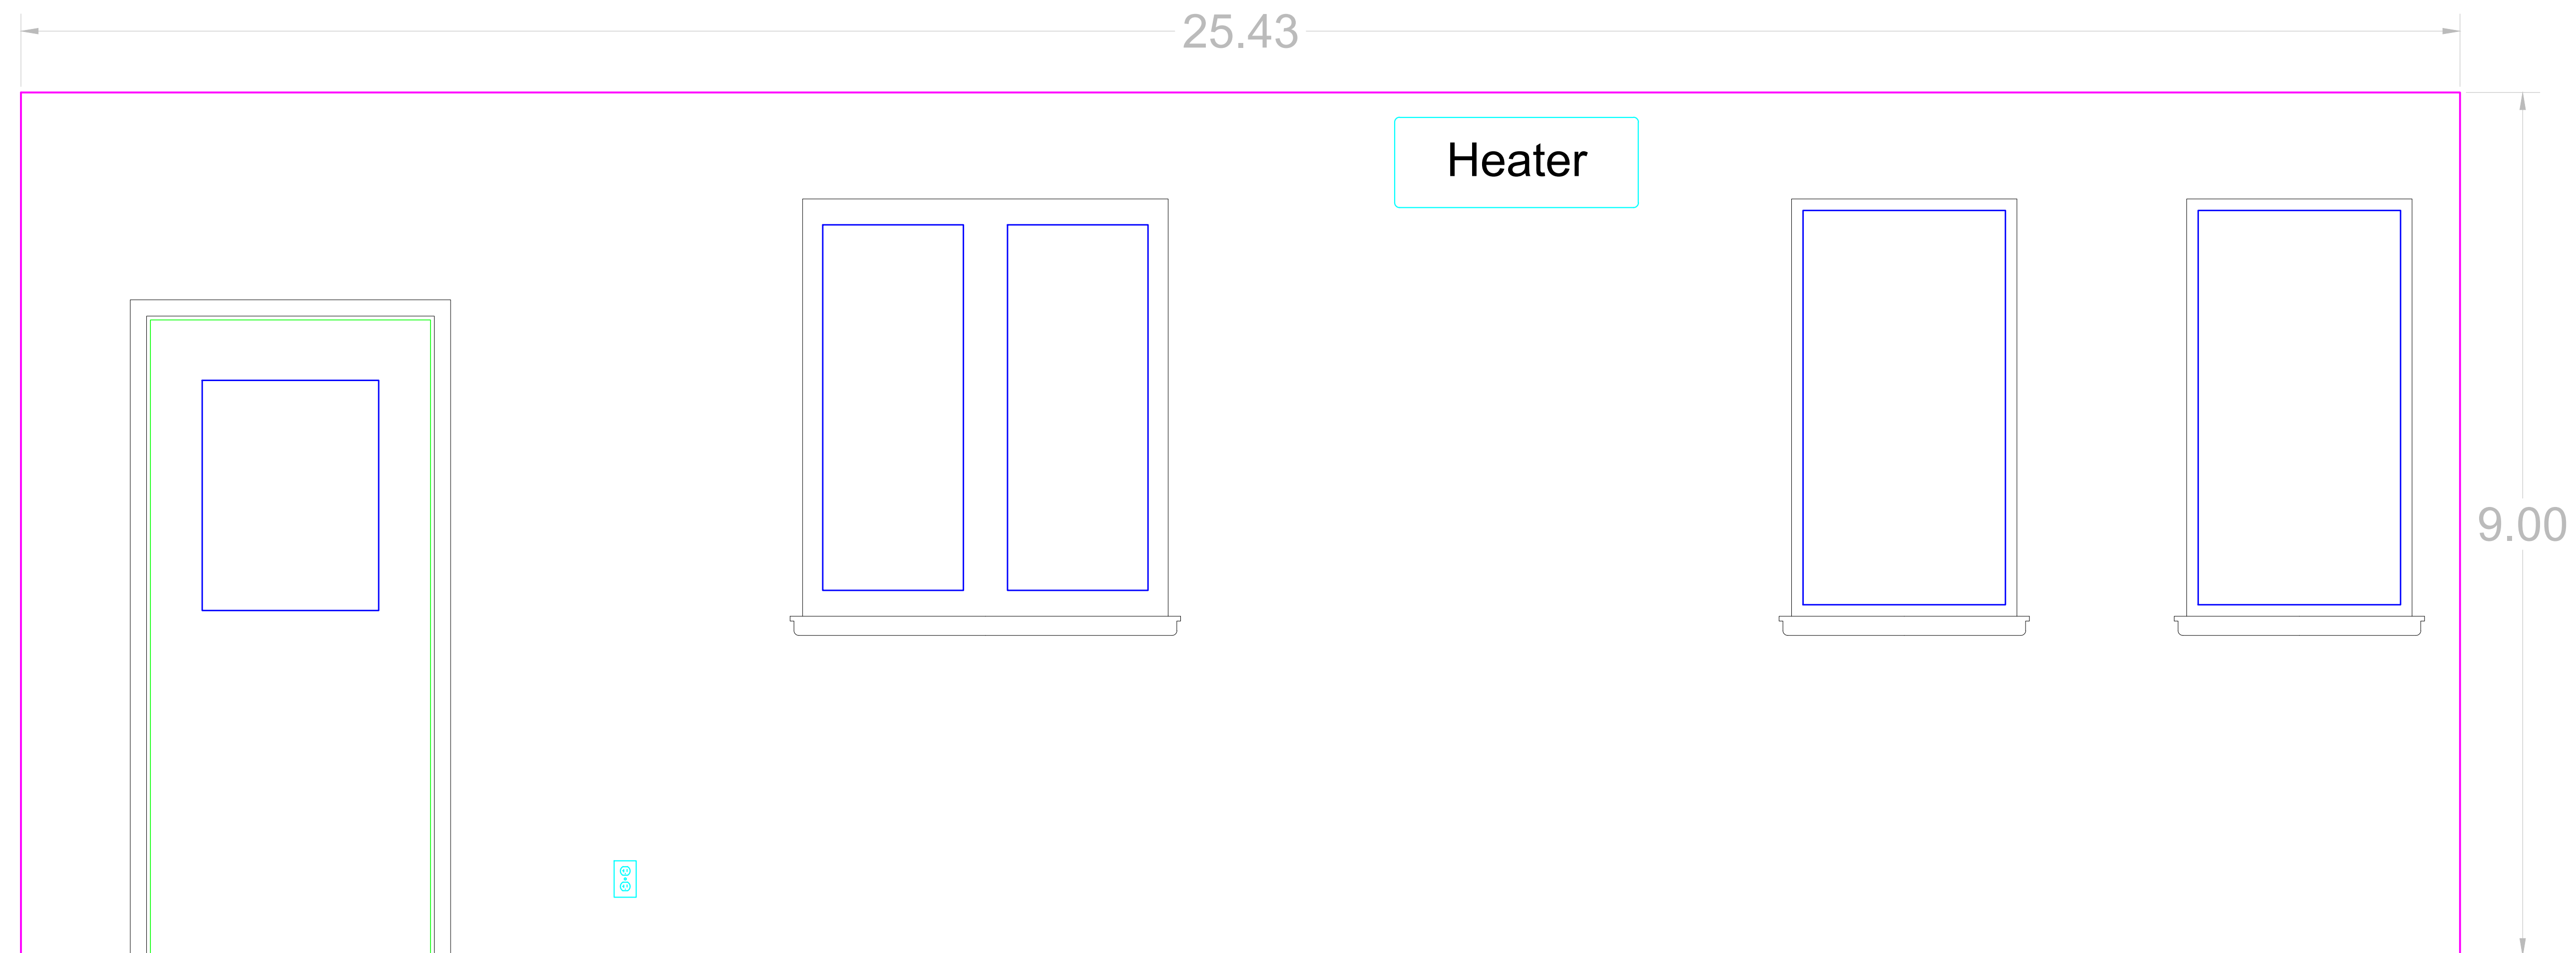

SCALE: 1" = 1'

WE
5

"Name"
Address City CA Zip Code

DESCRIPTION:

Projected
Ceiling

DATE: 4/12/17

SCALE: 1"=2'

DRAWN BY: DH

REVISIONS: --

SHEET
1 OF 1

